


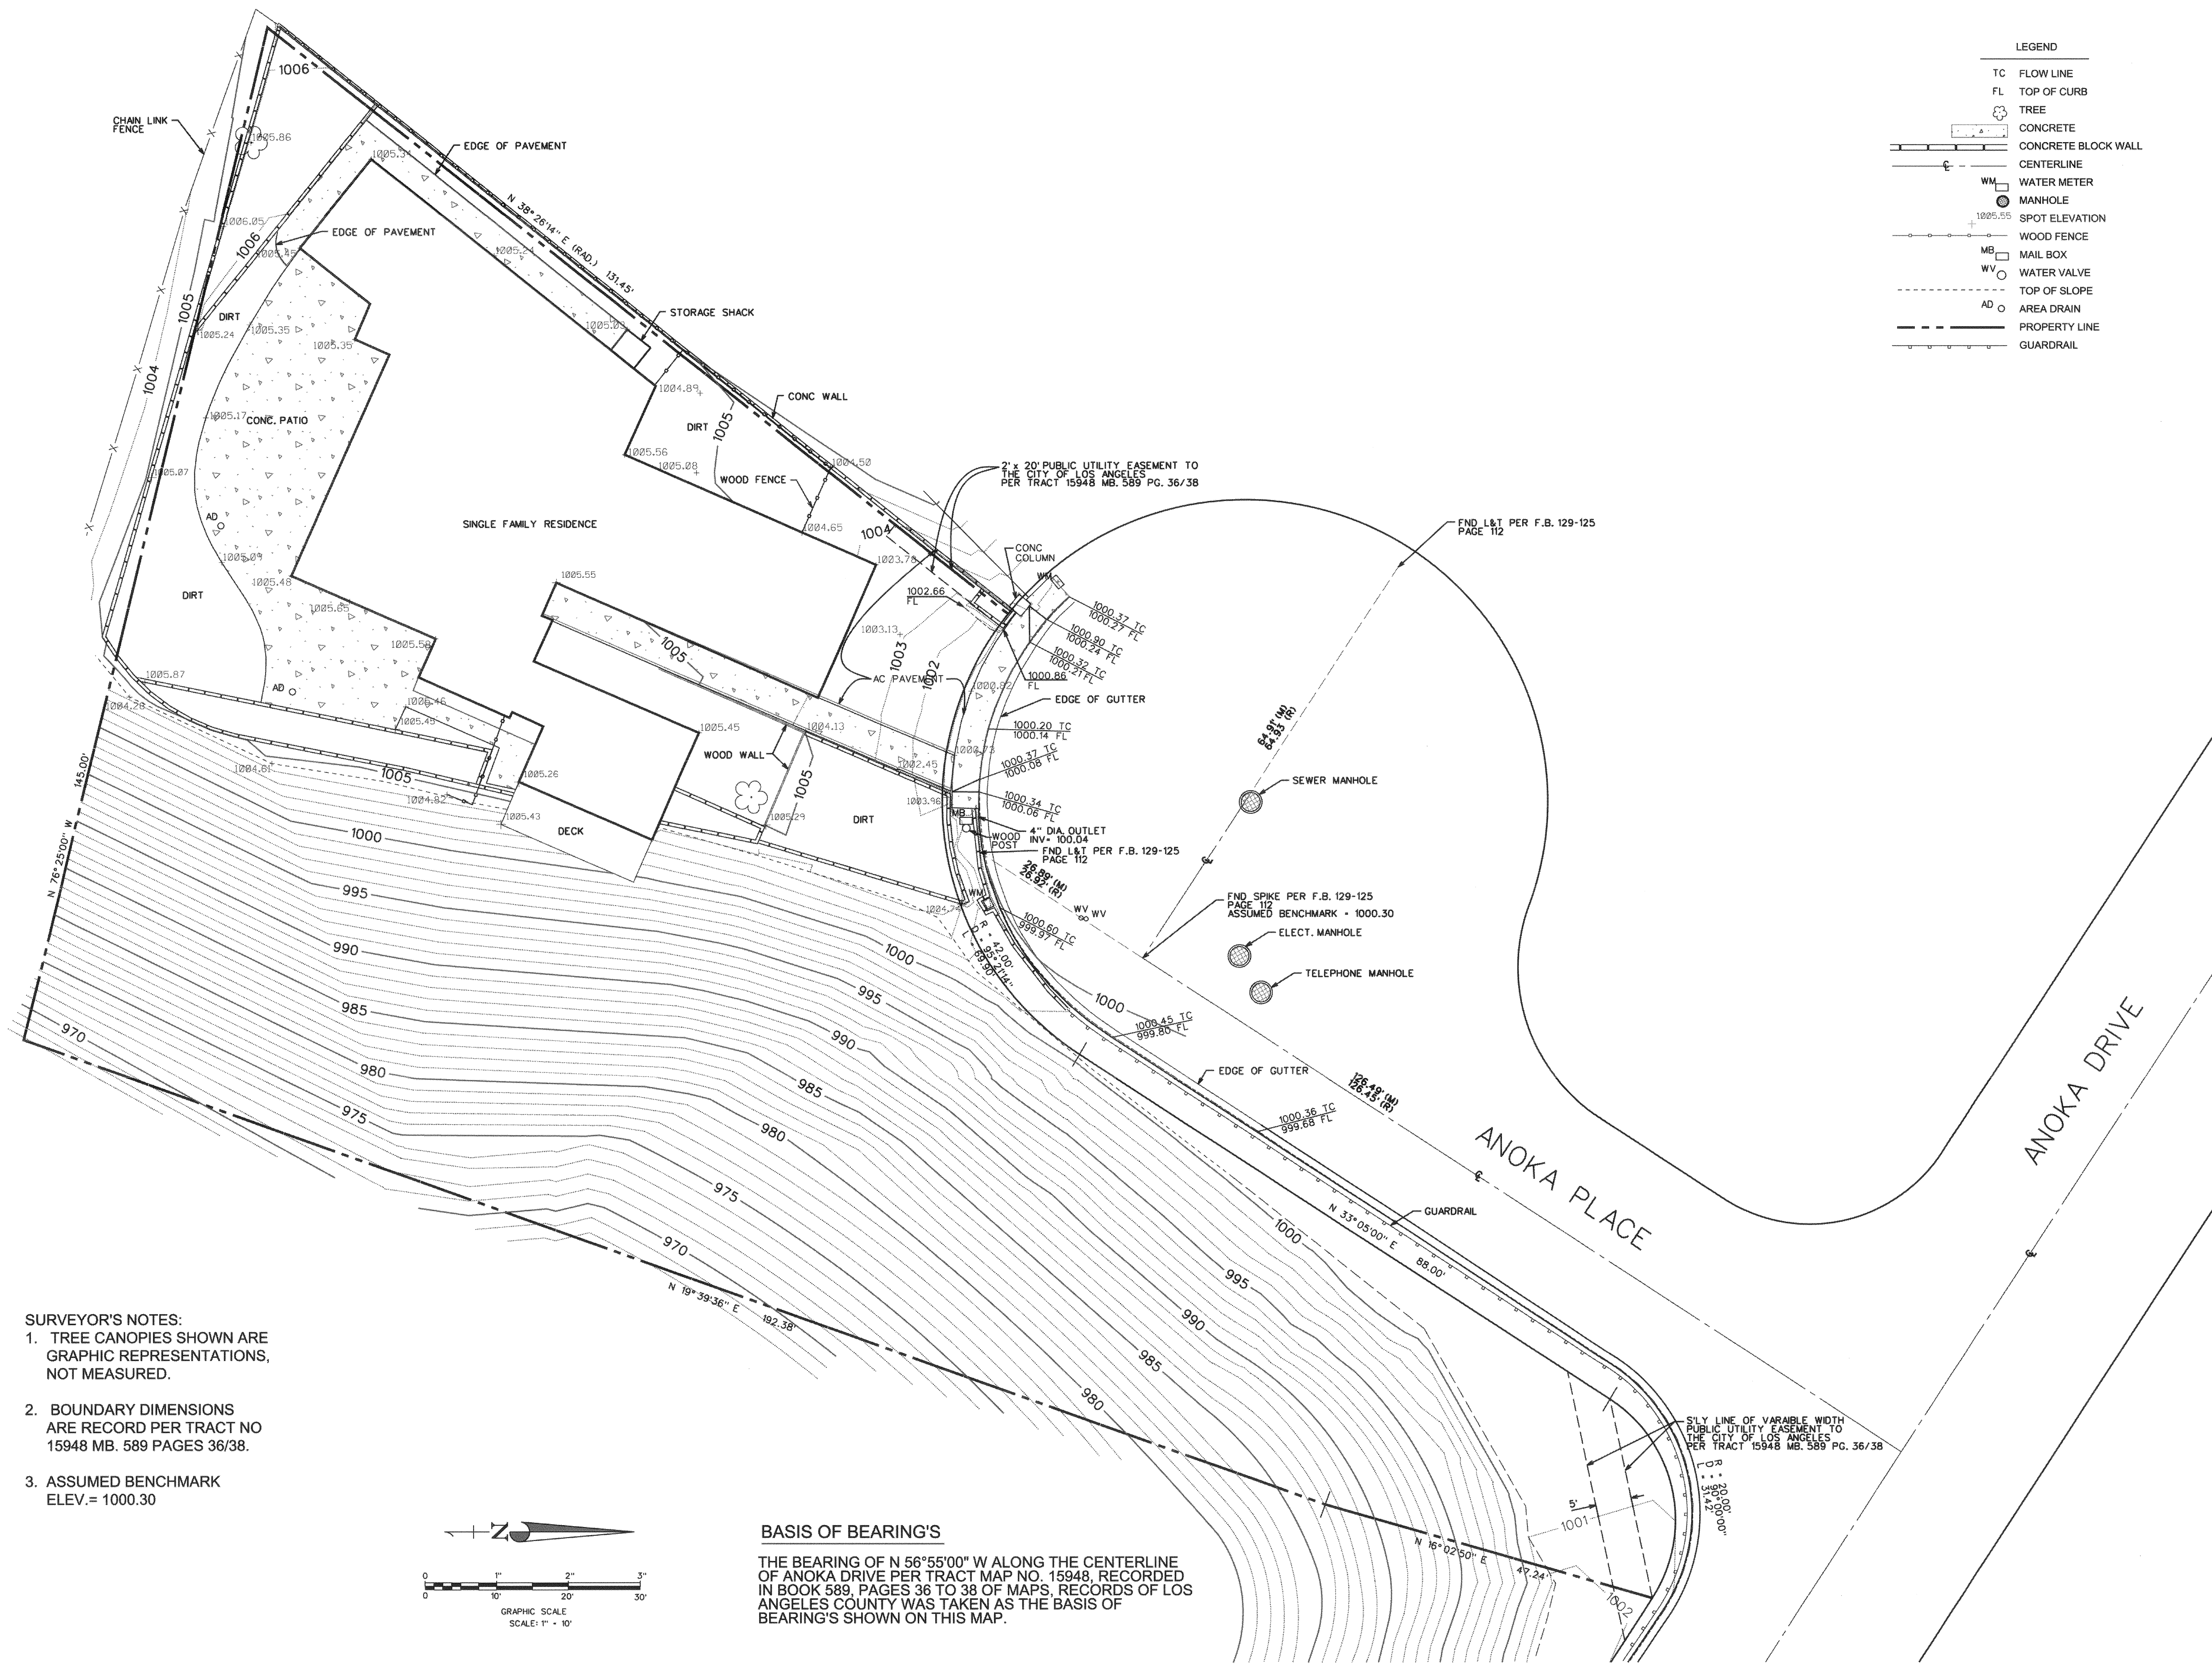

Advanced Engineering
& Consulting
22837 Ventura Blvd., Suite 100, Woodland Hills, CA 91364
(818) 222-7982 / (818) 222-7986 Fax


TOPOGRAPHIC SURVEY

LEGAL DESCRIPTION
LOT 12 OF TRACT 15948 IN THE
UNINCORPORATED COUNTY OF L.A.,
STATE OF CALIFORNIA, AS PER
MAPS RECORDED IN BOOK 589
PAGES 36/38 OF MAPS IN THE
OFFICE OF THE COUNTY
RECORDER OF SAID COUNTY

ADDRESS
1030 ANOKA PLACE.
LOS ANGELES, CA 90272

PREPARED FOR

Survey Date:
SEPTEMBER 9, 2014

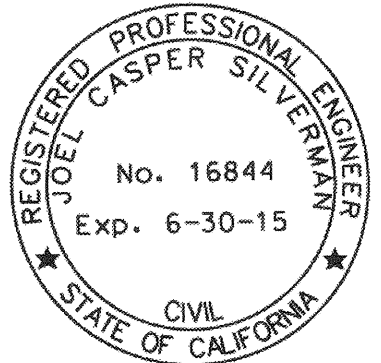

SHEET 1 OF 1

WHITE
PICKET
FENCE

212 26TH STREET, SUITE 124
SANTA MONICA, CA. 90402
tel: 310.213.1694
fax: 310.807.4183
www.whitepicketfence.com

OWNER:
TIMOTHY & SHERYL SCHEY
1030 N. Anoka Place
Pacific Palisades, Ca. 90272

CONSULTANTS:

STRUCTURAL ENGINEER:

BEROZ & ASSOC., INC.
5530 Corbin Ave, Suite 355
Tarzana, Ca. 91356
PH: 818 688-6389

CIVIL ENGINEER:

ADVANCED ENGINEERING
22837 Ventura Bl., Suite 100
Woodland Hills, Ca. 91364
PH: 818 222-7982

GEOTECHNICAL ENGINEER:

BYER GEOTECHNICAL INC.
1481 E. Chevy Chase Dr., Suite 200
Glendale, Ca. 91206
PH: 818 546-9559

ENERGY CALCULATIONS:

ALTERNATIVE ENERGY
SYSTEMS
915 E. Tujunga Avenue
Burbank, Ca. 91501
PH: 818 569-0243

PROJECT
1030 N. ANOKA PLACE
PACIFIC PALISADES
CA. 90272
DRAWING TITLE
SURVEY - EXISTING
SCALE
1" = 10'-0"

NO.	DATE	ISSUANCE
1	11.21.14	AS-BUILT PLAN
2	11.24.14	STUDY 1
3	01.08.15	STUDY 2
4	01.08.15	STUDY 3
5	01.13.15	HOA REVIEW
6	01.20.15	ENGINEER
7	01.24.15	REVISIONS
8	01.26.15	REVISIONS
9	01.28.15	ENGINEER
10	01.28.15	HOA REVIEW
11	03.02.15	PLAN CHECK
12	04.30.15	VERIFICATION

A2.0